

8 7 6 5 4 3 2 1

REVISIONS		
DATE	DESCRIPTION	BY.

D

D

C


C

B

B


A

A

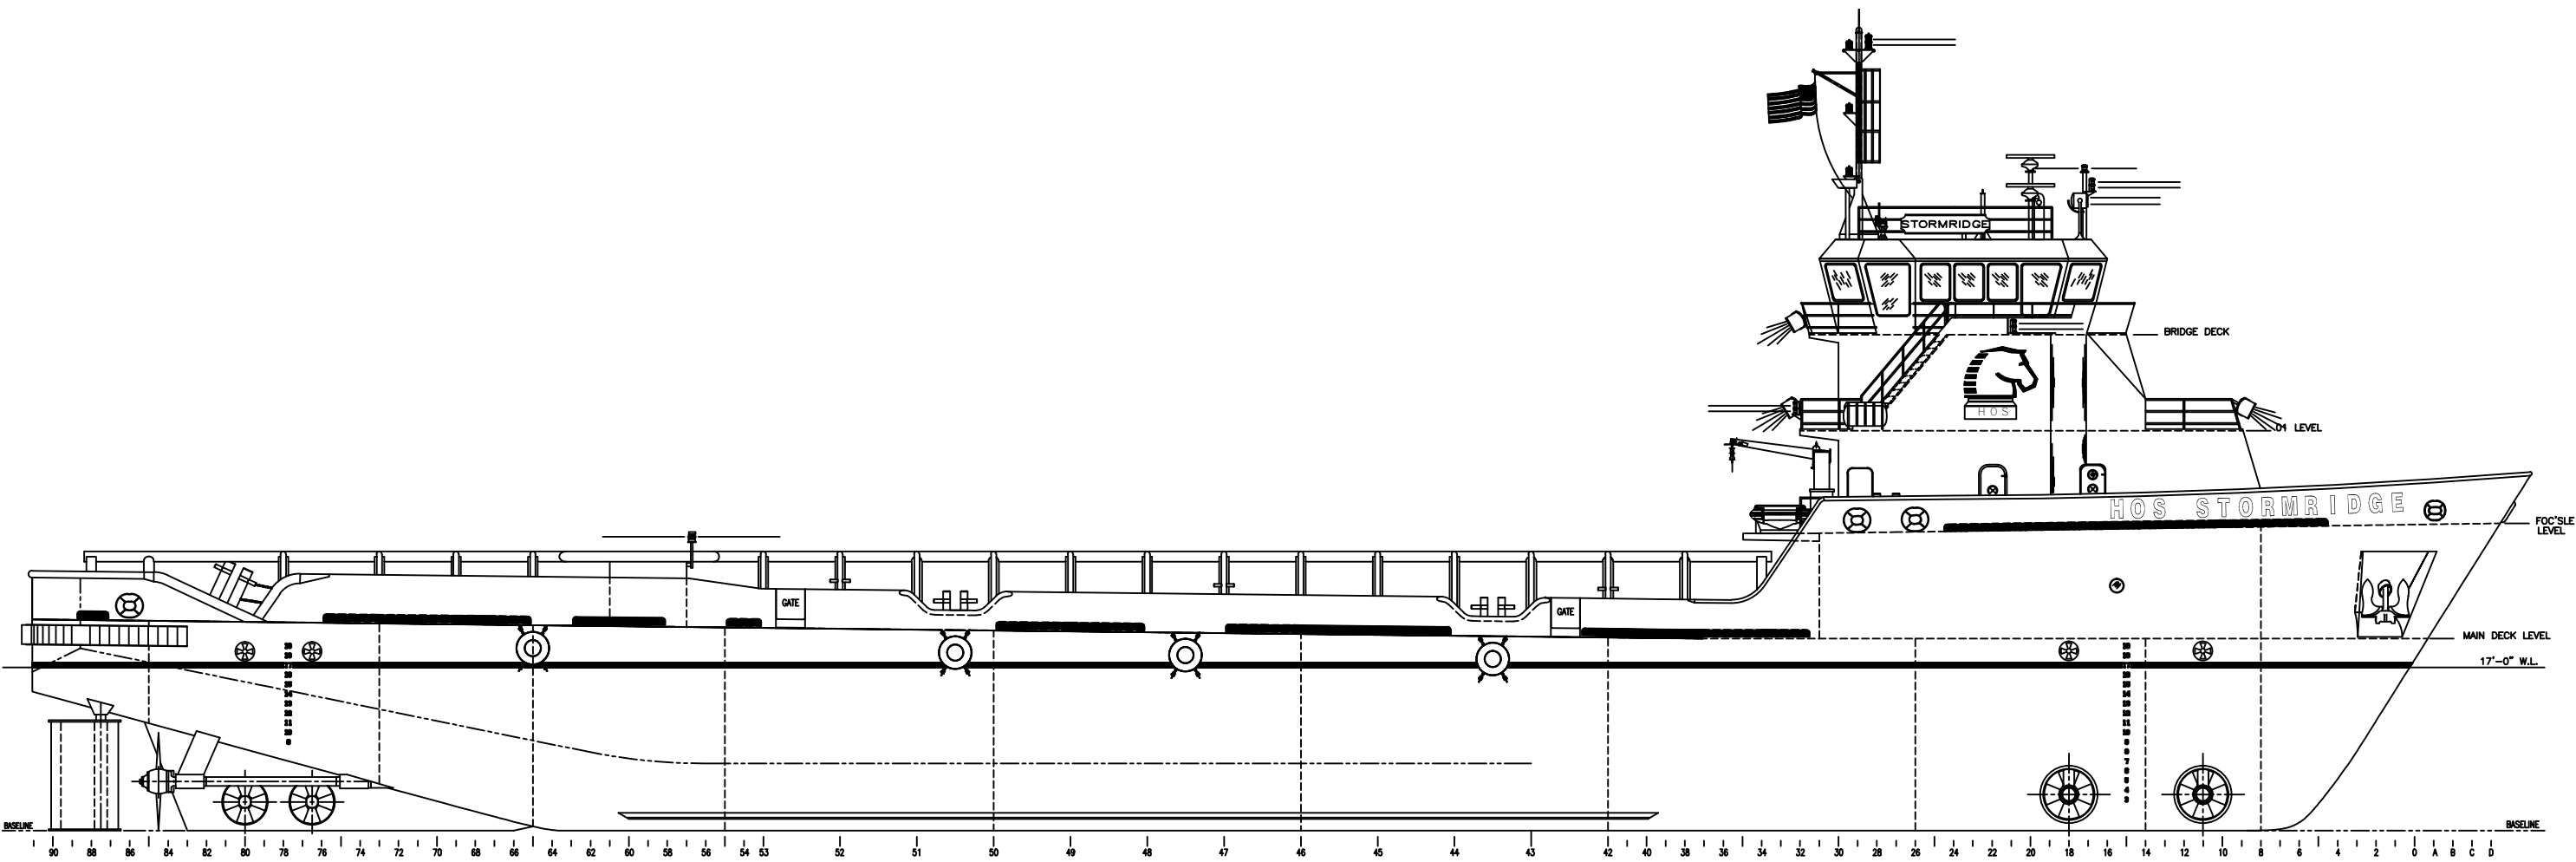

OUTBOARD PROFILE

HULL 90 HOS STORMRIDGE AS BUILT

		<small>THIS DRAWING, DESIGN CONCEPT AND SPECIFICATIONS ARE THE PROPERTY OF HORNBECK OFFSHORE SERVICES AND ARE FURNISHED ON A CONFIDENTIAL BASIS WITH AN EXPRESSED UNDERSTANDING THAT THEY WILL NOT BE COPIED IN ANY MANNER USED FOR MANUFACTURING, SOLD, TRANSFERRED, NOR USED TO THE DETRIMENT OF SAID FIRM WITHOUT WRITTEN PERMISSION. HOS ©</small>	
<b>HORNBECK OFFSHORE SERVICES</b>		260'-0" X 60'-0" X 21'-0" W	
DRAWN BY: EBDG	OUTBOARD PROFILE		
CH'KD. BY: JAT	SCALE: 1/8"=1'-0"	DATE: 1/19/01	REV.
APP'D. BY: JAT	DRAWING # 1.001	ASI HULL #90	4
APP'D. BY:	SHEET 1 OF 1	1	

8 7 6 5 4 3 2 1